Valid for Proposed Construction Only

- मंजूर -

आयुक्त, स.सं.न.र./अमरावती/यांचे दि. 24/12/2008 च्या आदेशान्वये इमारत परवाना व आरंभ प्रमाणपत्र
क्र.अमरावती/स.सं.न.र./बां.प./इ.क्र.2636 दि.24/12/2008
मधील अटींना अनुसरून प्रस्तावित इमारत नकाशात लाल रंगाने दुरुस्ती सुचविल्याप्रमाणे मंजूरी देण्यात येत आहे.

सहाय्यक संचालक नगररचना
महानगर पालिका, अमरावती.

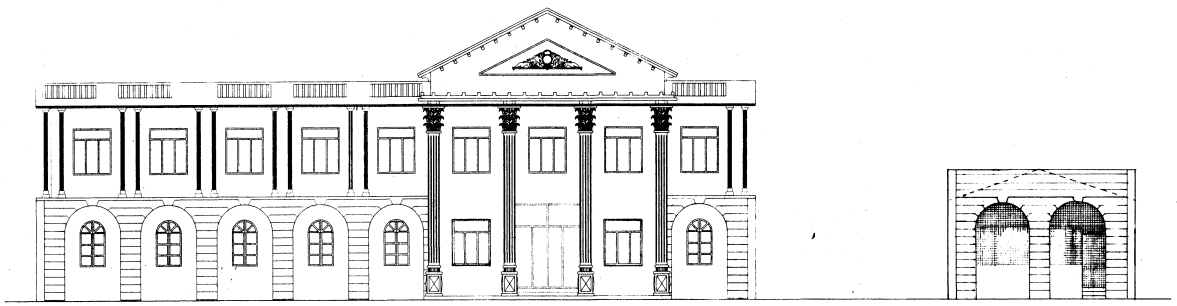

FRONT ELEVATION OF PROPOSED CASUALTY BLOCK

ELEVATION OF PROPOSED WAITING - RADIOLOGY DEPT.

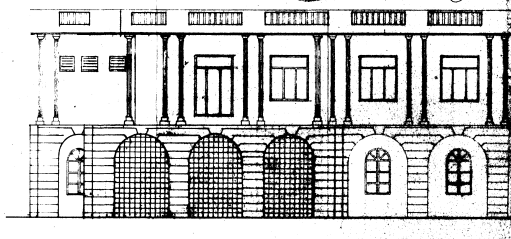

REAR SIDE ELEVATION - **PROPOSED 20 BEDED WARD**

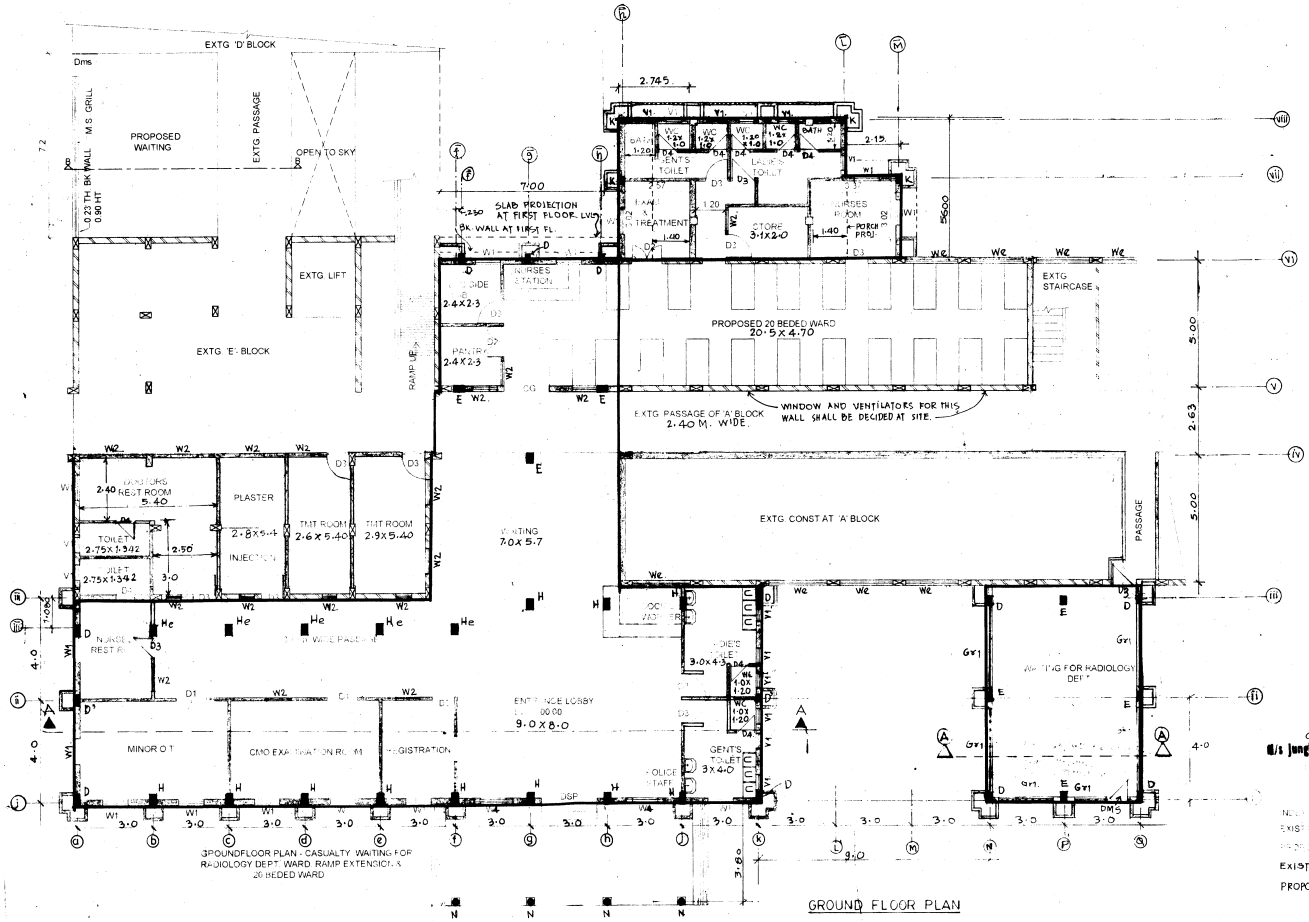

GROUND FLOOR PLAN

SCHEDULE OF OPENINGS

TYPE	SIZE	DESCRIPTION
DSP	B XH	FRONT ENT. DOOR (ENT LOBBY)
D2	1.20 X 2.10	NOVAPAN SHUTTER DOOR
D3	0.90 X 2.1	NOVAPAN SHUTTER DOOR
D4	0.75 X 2.10	NOVAPAN SHUTTER DOOR (TOILET)
W1	1.00 X 1.80	M.S. GLAZED WINDOW
W2	1.00X1.20	AL. WINDOW (INTERNAL)
CG	1.80 X 2.1	COLAPSEBLE GATE
V1	0.60 X 0.60	M.S. LOUVERED VENTI.
Gv1	B XH.	M.S. GRILL [illegible]
DMS.	0.9 X 2.10	M.S. GRILL GATE
We	—	EXISTING WINDOW.
W4	1.50 X 1.80	AL. WINDOW.

(Red Mark) - Total B/up Area = 310.88 Sq.mt.

M.P. Magre.
CA/1997/110574
M/s Junghare Designers & Consultants
91, Shivaji Nagar,
NAGPUR - 440010.

EXISTING BRICKWORK
PROPOSED BRICKWORK

1.	COLUMNS RELOCATED.	29TH NOV 08	
REVISION.	DESCRIPTION.	DATE.	SIGN.

JUNGHARE DESIGNERS & CONSULTANTS

"MATRUCHHAYA", 91, SHIVAJINAGAR, NAGPUR-10. PH.NO. 2248851.

JOB NO. 800 / 2004/ PHASE V	DRG. NO. 1/ SUB	SCALE 1:100	DATE 1[illegible]2005
CONTENTS	GROUND FL. PLAN OF CASUALTY, RAMP EXTENSION, WAITING FOR RADIOLOGY DEPT AND ELEVATIONS.		
PROJECT	DR. PANJABRAO DESHMUKH MEMORIAL MEDICAL COLLEGE, HOSPITAL & RESEARCH CENTRE, AMARAVATI.		
OWNER	SHRI SHIVAJI EDUCATION SOCIETY, AMARAVATI.		
DESIGNED	[signature]	OWNER	NORTH
DEALT	BANDU HUMNEY	Secretary Shri Shivaji Edu. Society Amravati.	
CHECKED	[signature]		
APPROVED			